


SE 1/4 SEC 22 T2N R1W MDBM
 A- POR TR 8448 MB 494-27 (VISTA DEL MAR) 8/25/06
~~POR PCL "C" 108PM2 10/24/83~~
 2- 182PM36 12/24/01
~~POR PCL "C" 193PM46 6/21/05~~

18 TO BK. 92-03 17

1"=400'

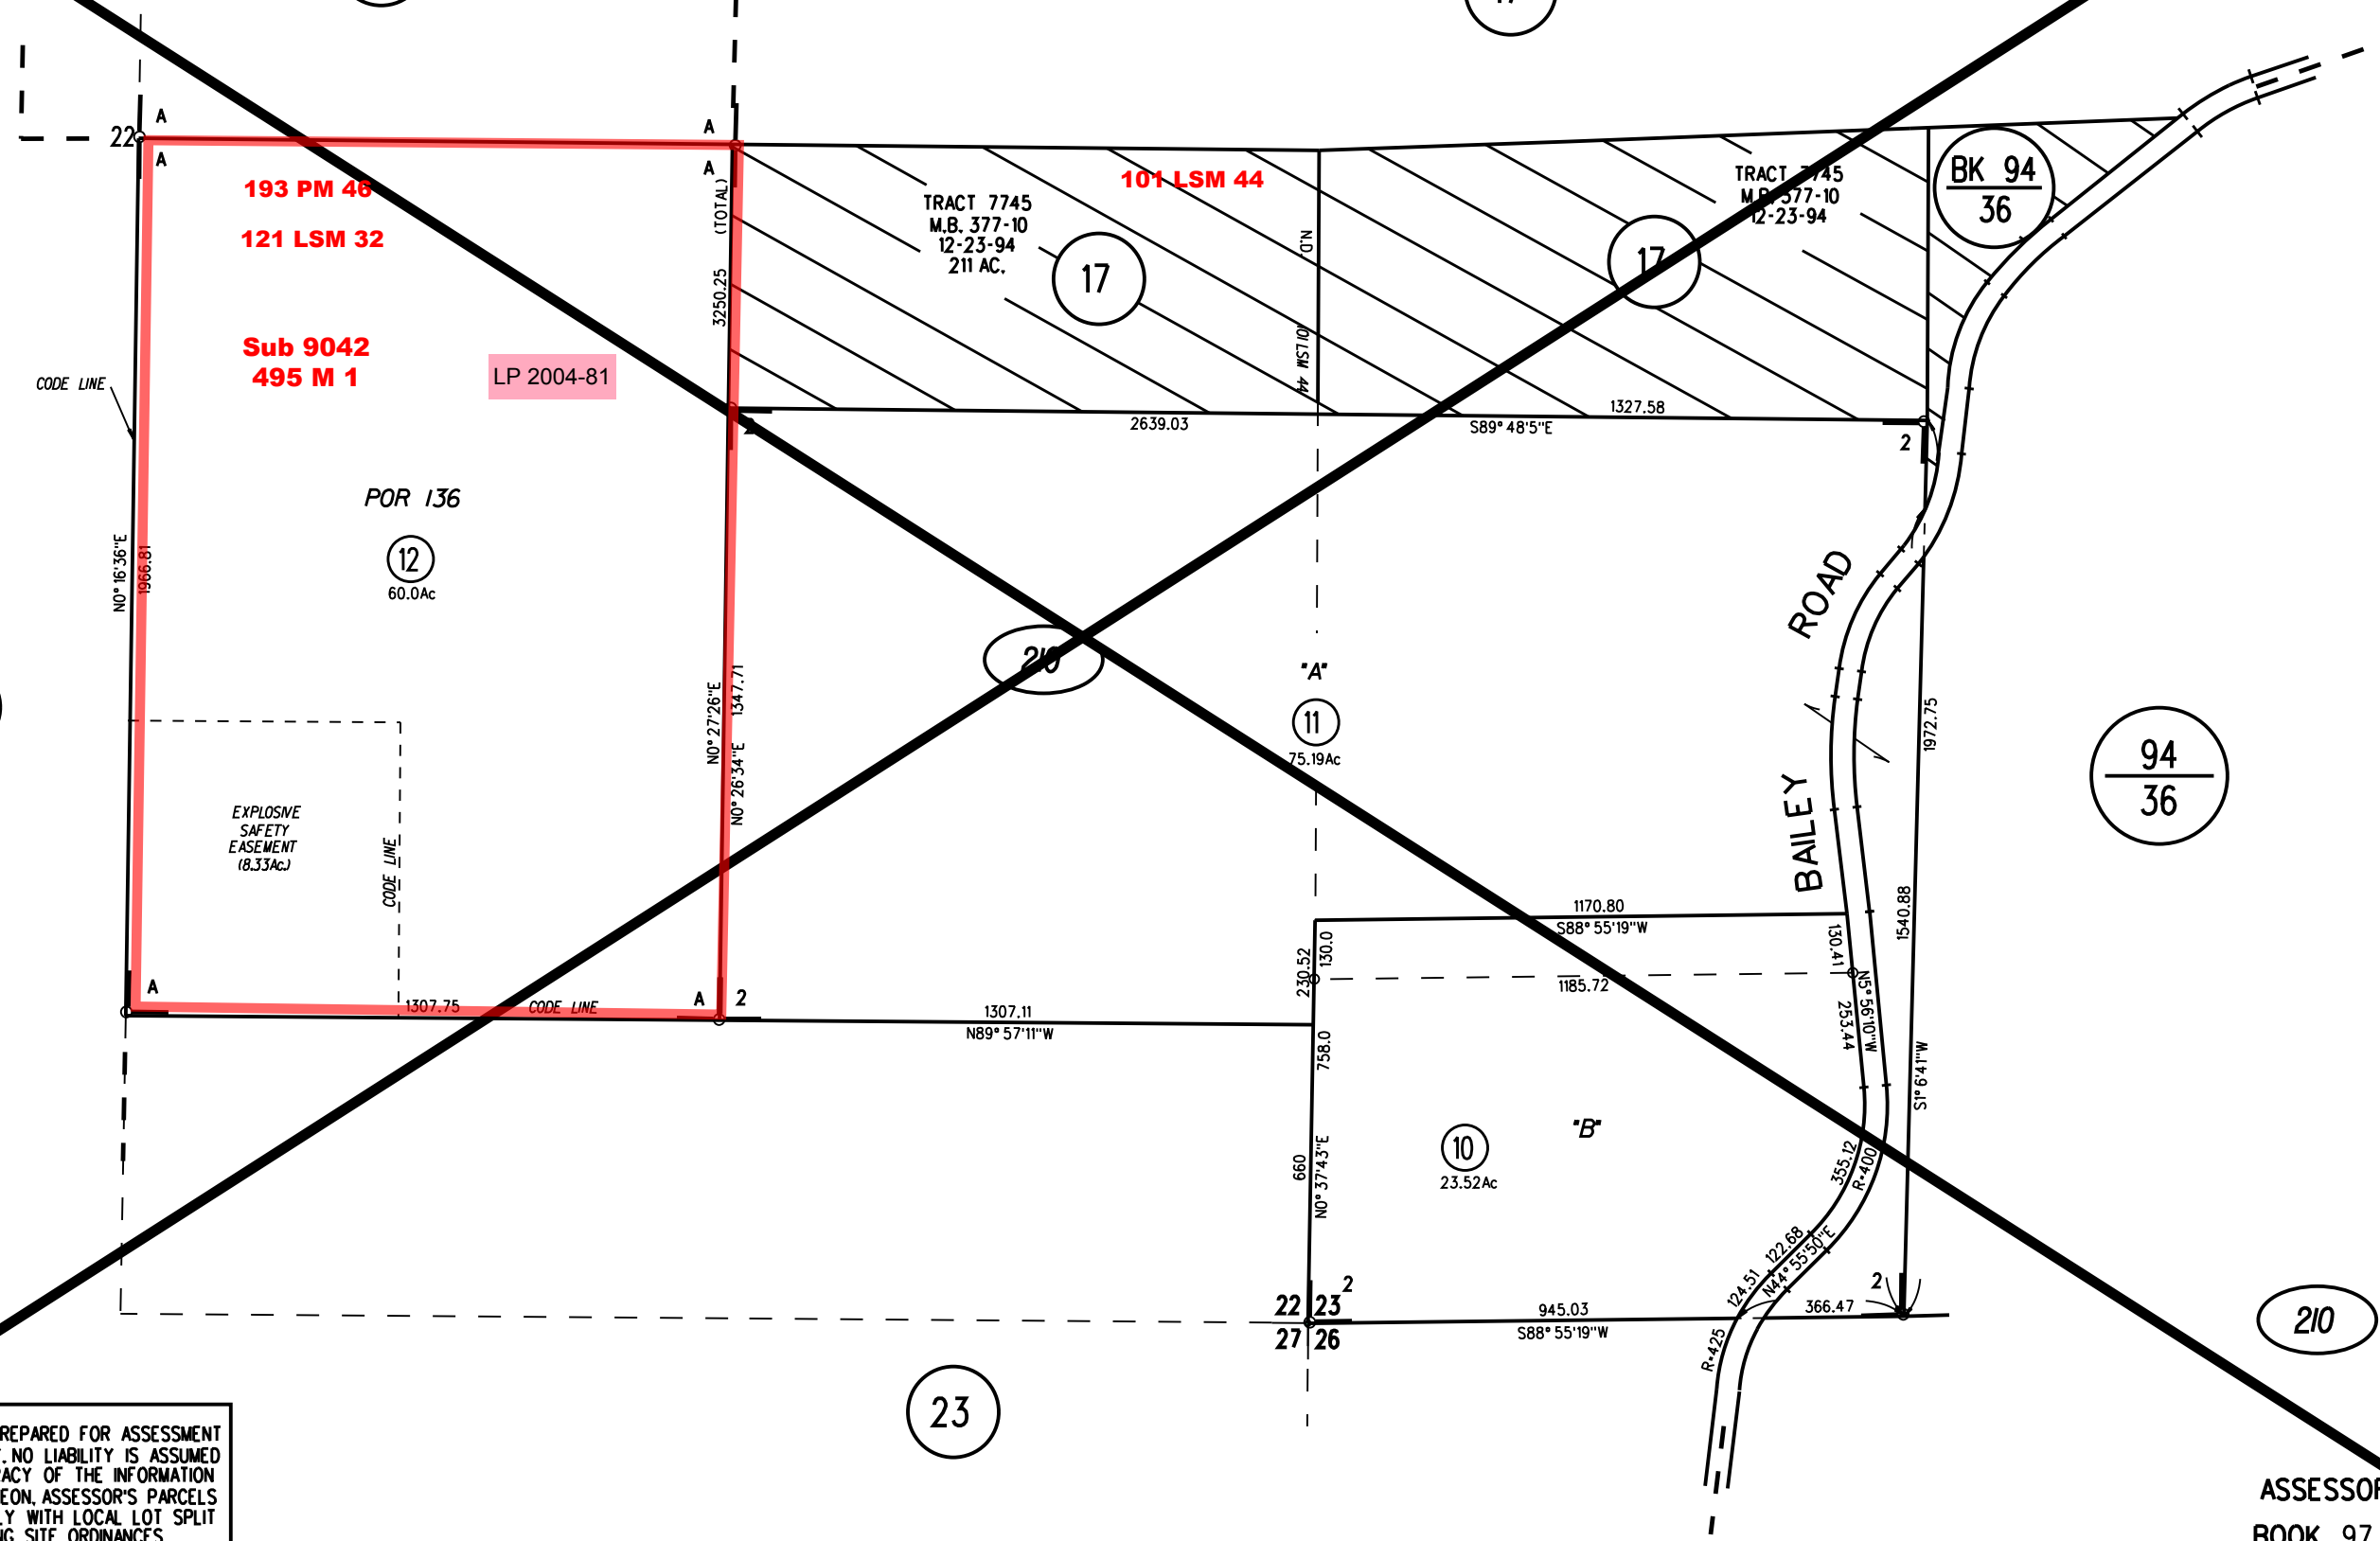

NOTE: THIS MAP WAS PREPARED FOR ASSESSMENT PURPOSES ONLY. NO LIABILITY IS ASSUMED FOR THE ACCURACY OF THE INFORMATION DELINEATED HEREON. ASSESSOR'S PARCELS MAY NOT COMPLY WITH LOCAL LOT SPLIT OR BUILDING SITE ORDINANCES.